

ANNOTATED MARKED-UP
DRAWINGS



100

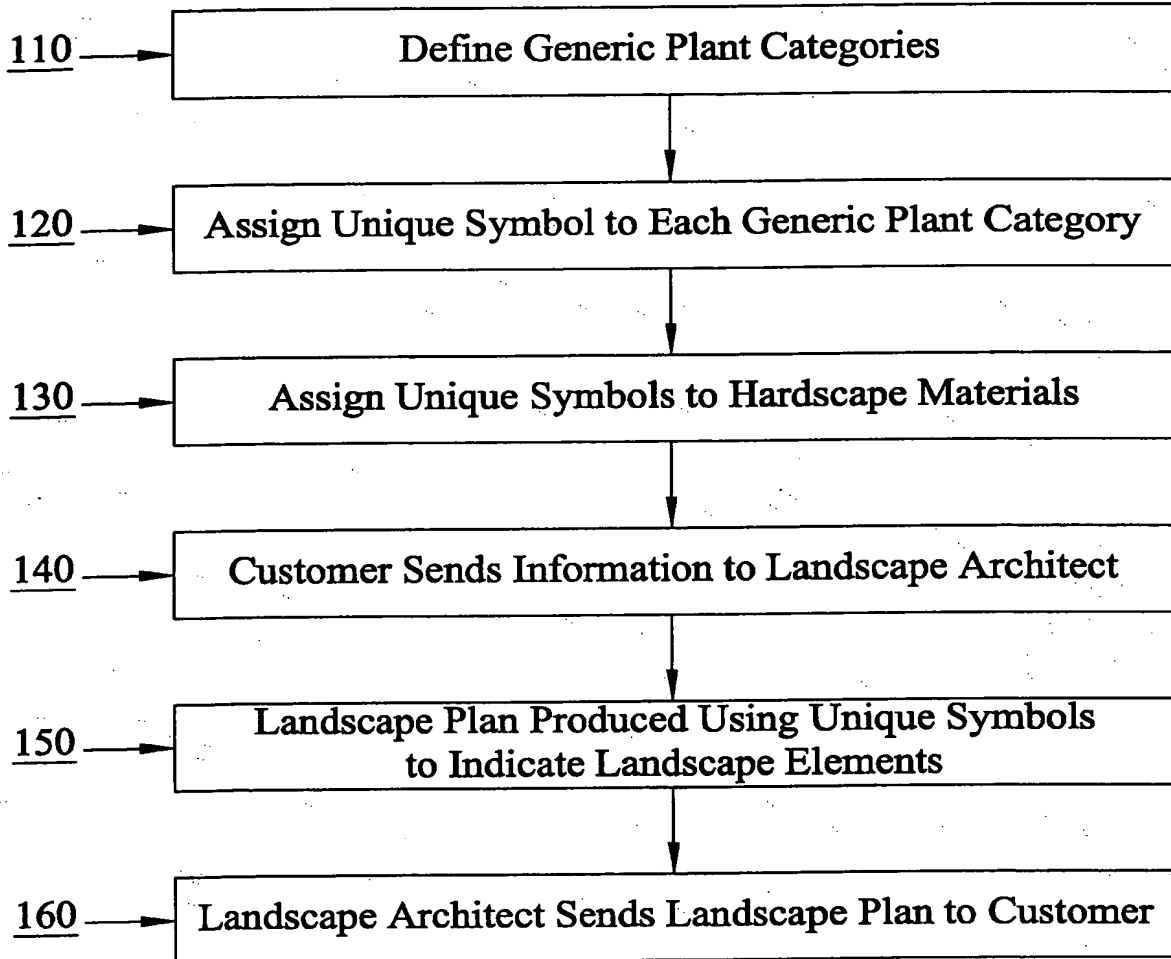




FIGURE 1

ANNOTATED MARKED-UP
DRAWINGS



FIGURE 2

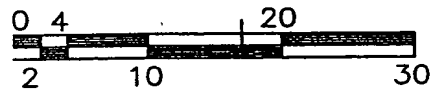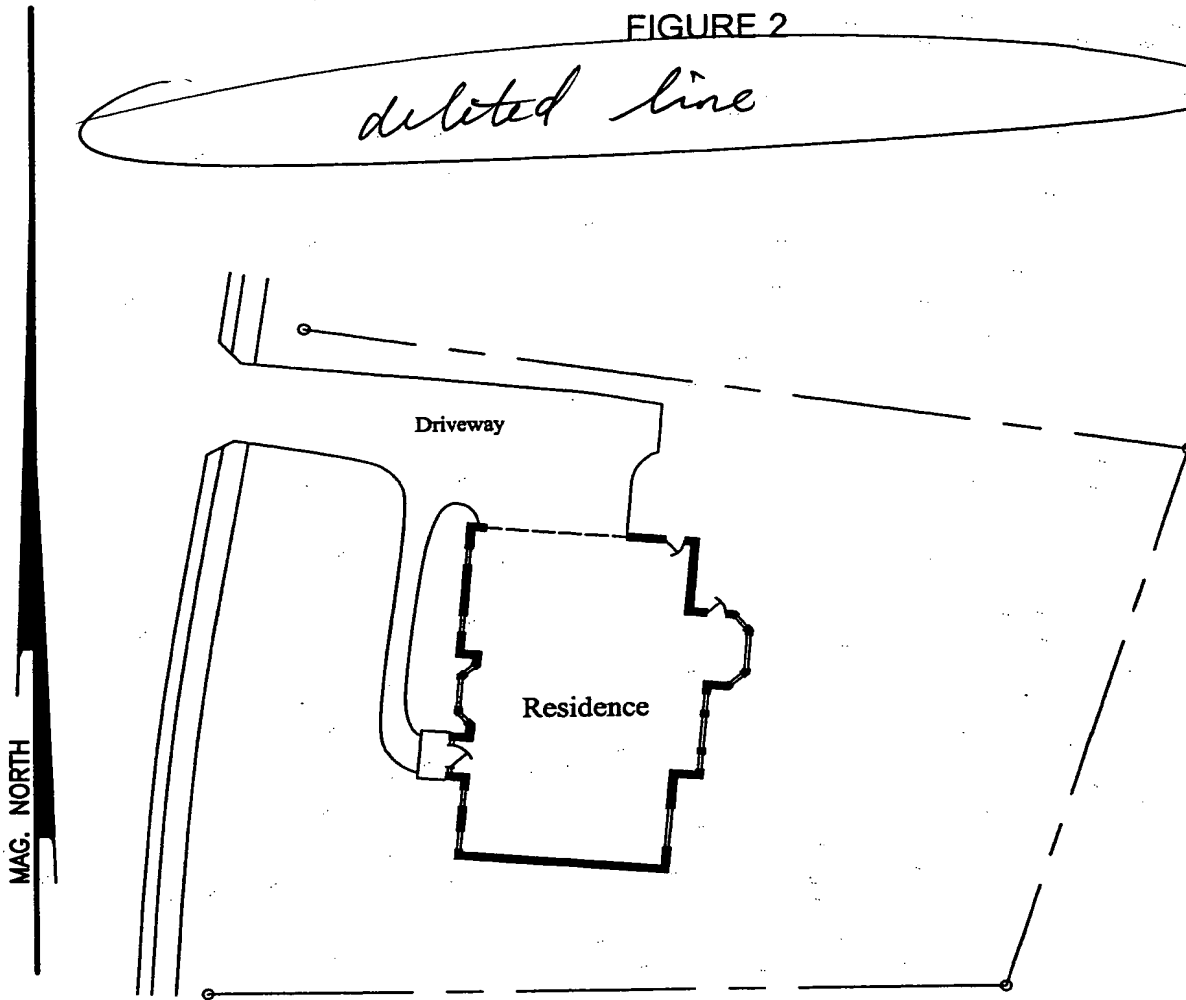deleted line



LEGEND

WM - WATER METER	R/W - RIGHT OF WAY	R - RADIUS	PP - POWER POLE
WV - WATER VALVE	IPP - IRON PIN PLACED	- X - X -	FENCE
PK - PK NAIL PLACED	IPF - IRON PIN FOUND	— — — —	LAND LOT LINE
GM - GAS METER	CM - CONCRETE MARKER	⊙ — — — —	CENTER LINE
LP - LIGHT POLE	CH. - CHORD	— ⚡ — — —	POWER LINE
	L OR A - LENGTH OF CURVE	B/L -	BUILDING SETBACK LINE

fixed margin

ANNOTATED MARKED-UP
DRAWINGS

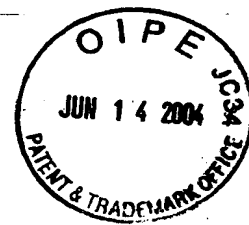
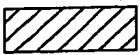






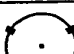
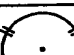









FIGURE 4

Symbol	Key	Quantity	Plant Type	Characteristics
	ACB	85	Annual Color Bed	Annual Flowers measured in square feet.
	EGC	250	Evergreen Groundcover	Spreading evergreen plant material up to 18" in height measured in square feet.
	DGC	100	Deciduous Groundcover	Spreading deciduous plant material up to 18" in height measured in square feet.
	PB	200	Perennial Bed	Perennial Flowering Plants measured in square feet.
	SsFt	77	Small Shrub Fine Texture	Shrub up to 36" in height and width. Leaf size less than 3/4"
	SsMt	76	Small Shrub Medium Texture	Shrub up to 36" in height and width. Leaf size of 3/4" - 2"
	SsCt	21	Small Shrub Coarse Texture	Shrub up to 36" in height and width. Leaf size greater than 2"
	MsFt	26	Medium Shrub Fine Texture	Shrub 36" - 60" in height and width. Leaf size less than 3/4"
	MsMt	12	Medium Shrub Medium Texture	Shrub 36" - 60" in height and width. Leaf size of 3/4" - 2"
	MsCt	7	Medium Shrub Coarse Texture	Shrub 36" - 60" in height and width. Leaf size greater than 2"
	LsFt	1	Large Shrub Fine Texture	Shrub greater than 60" in height and width. Leaf size less than 3/4"
	LsMt	6	Large Shrub Medium Texture	Shrub greater than 60" in height and width. Leaf size of 3/4" - 2"
	LsCt	24	Large Shrub Coarse Texture	Shrub greater than 60" in height and width. Leaf size greater than 2"
	Small Tree	13	Small Tree	Tree less than 25' tall
	Med. Tree	4	Medium Tree	Tree 25' - 40' tall
	Large Tree	4	Large Tree	Tree greater than 40' tall